


AS BUILT
V. David Welch Eng. & Surv.
 SANDPOINT, IDAHO 83864
 FILE WESTWOOD SEWER
 SCALE 1" = 60'
 DATE 9-73
 DRAWING NO. 97



LEGEND
 O MANHOLE
 --- SEWER LINE
 - - - WATER CROSSING

SCALE 1" = 60'

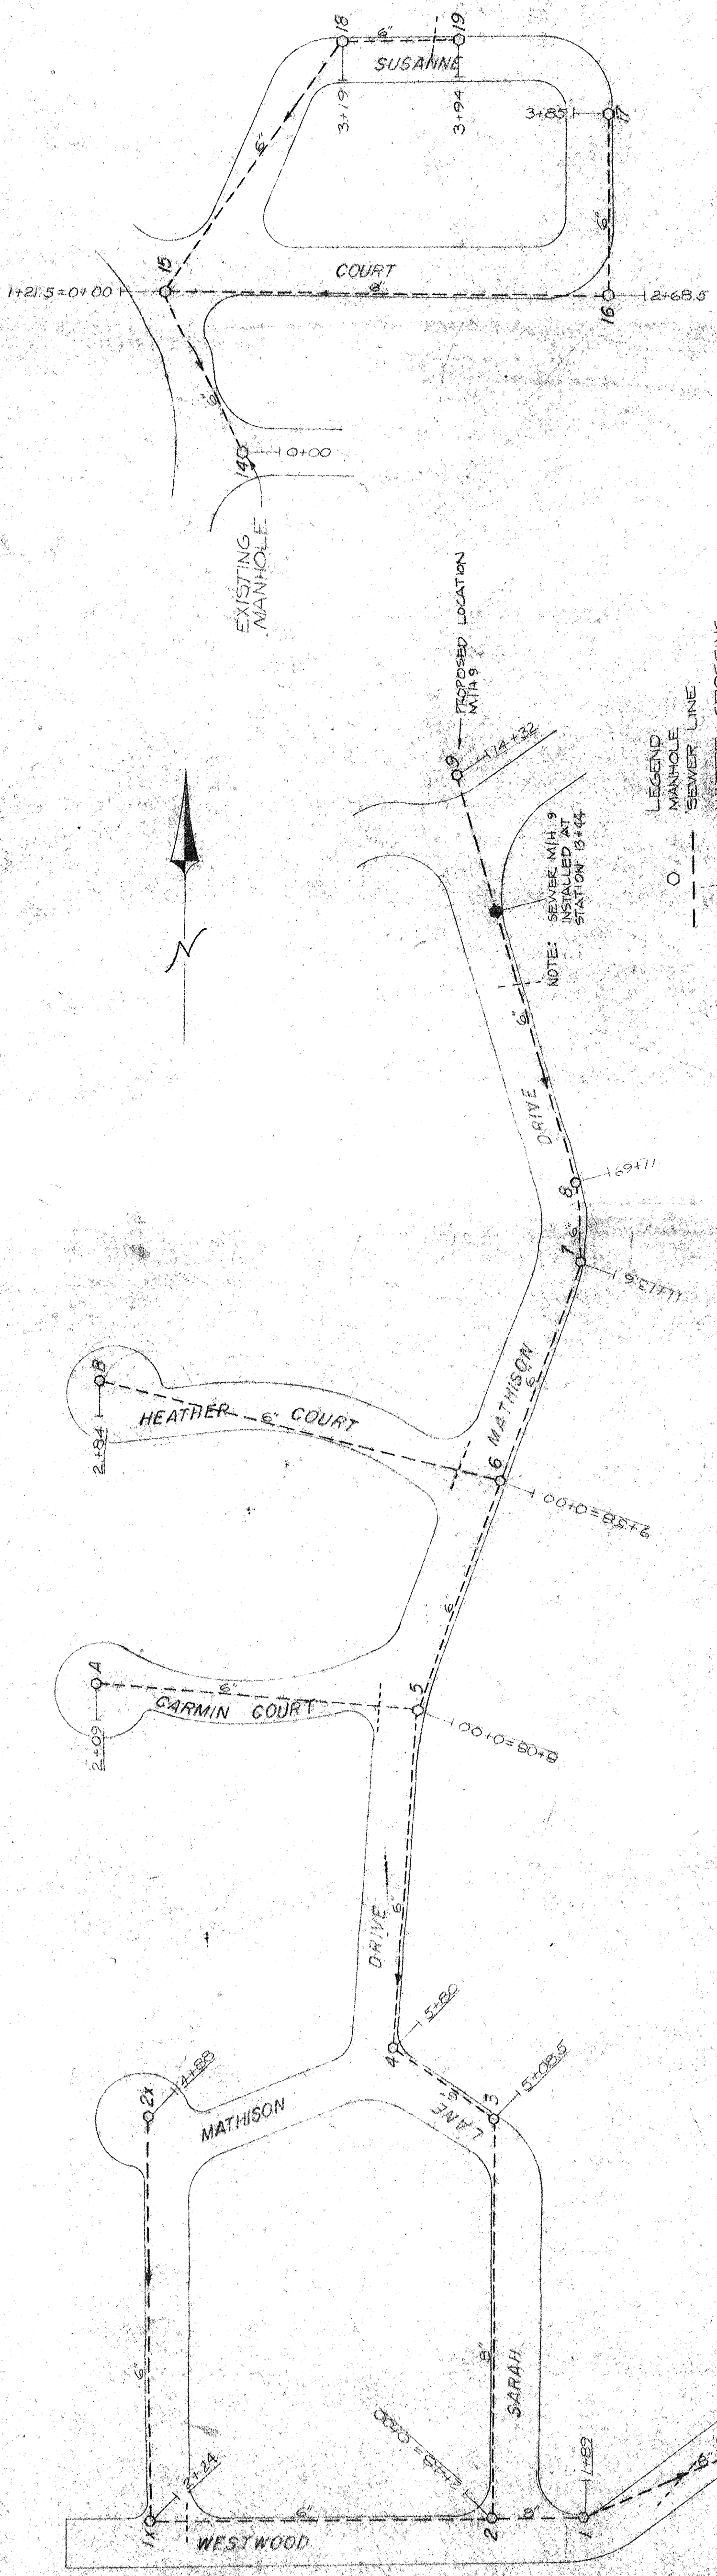